



Watowan County Road Map

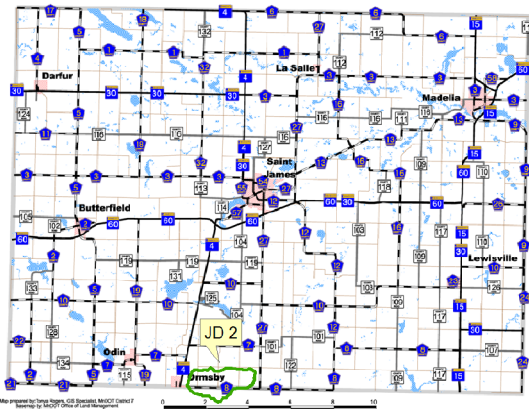

Judicial Ditch 2

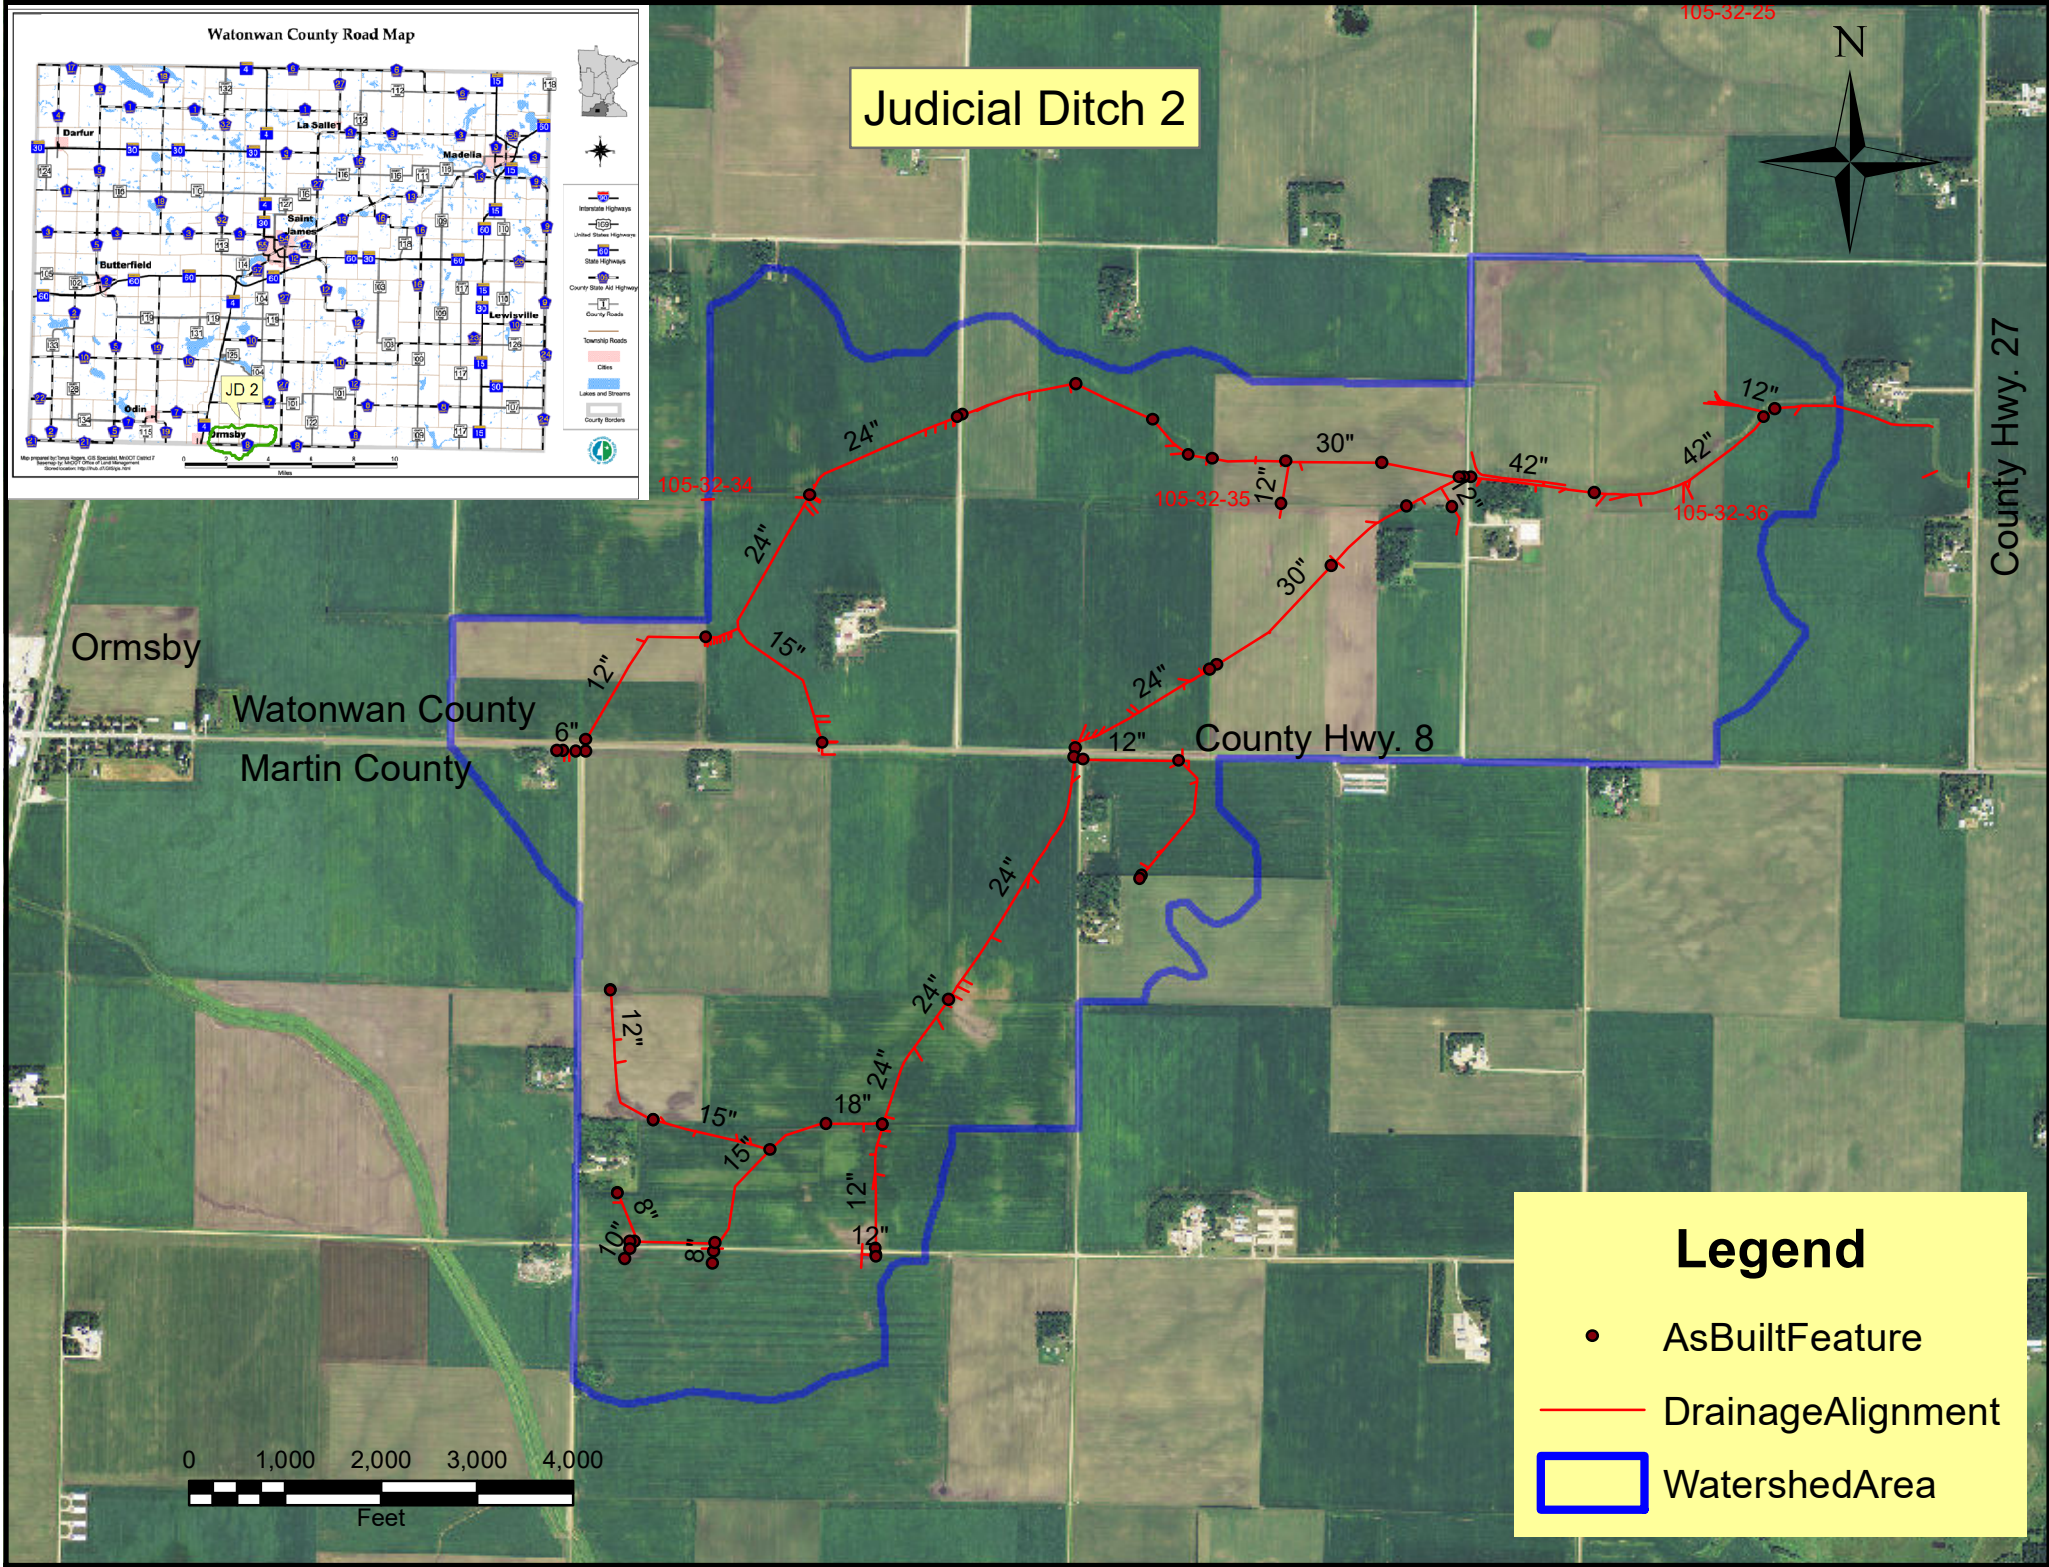

**Legend**

- AsBuiltFeature
- DrainageAlignment
- WatershedArea